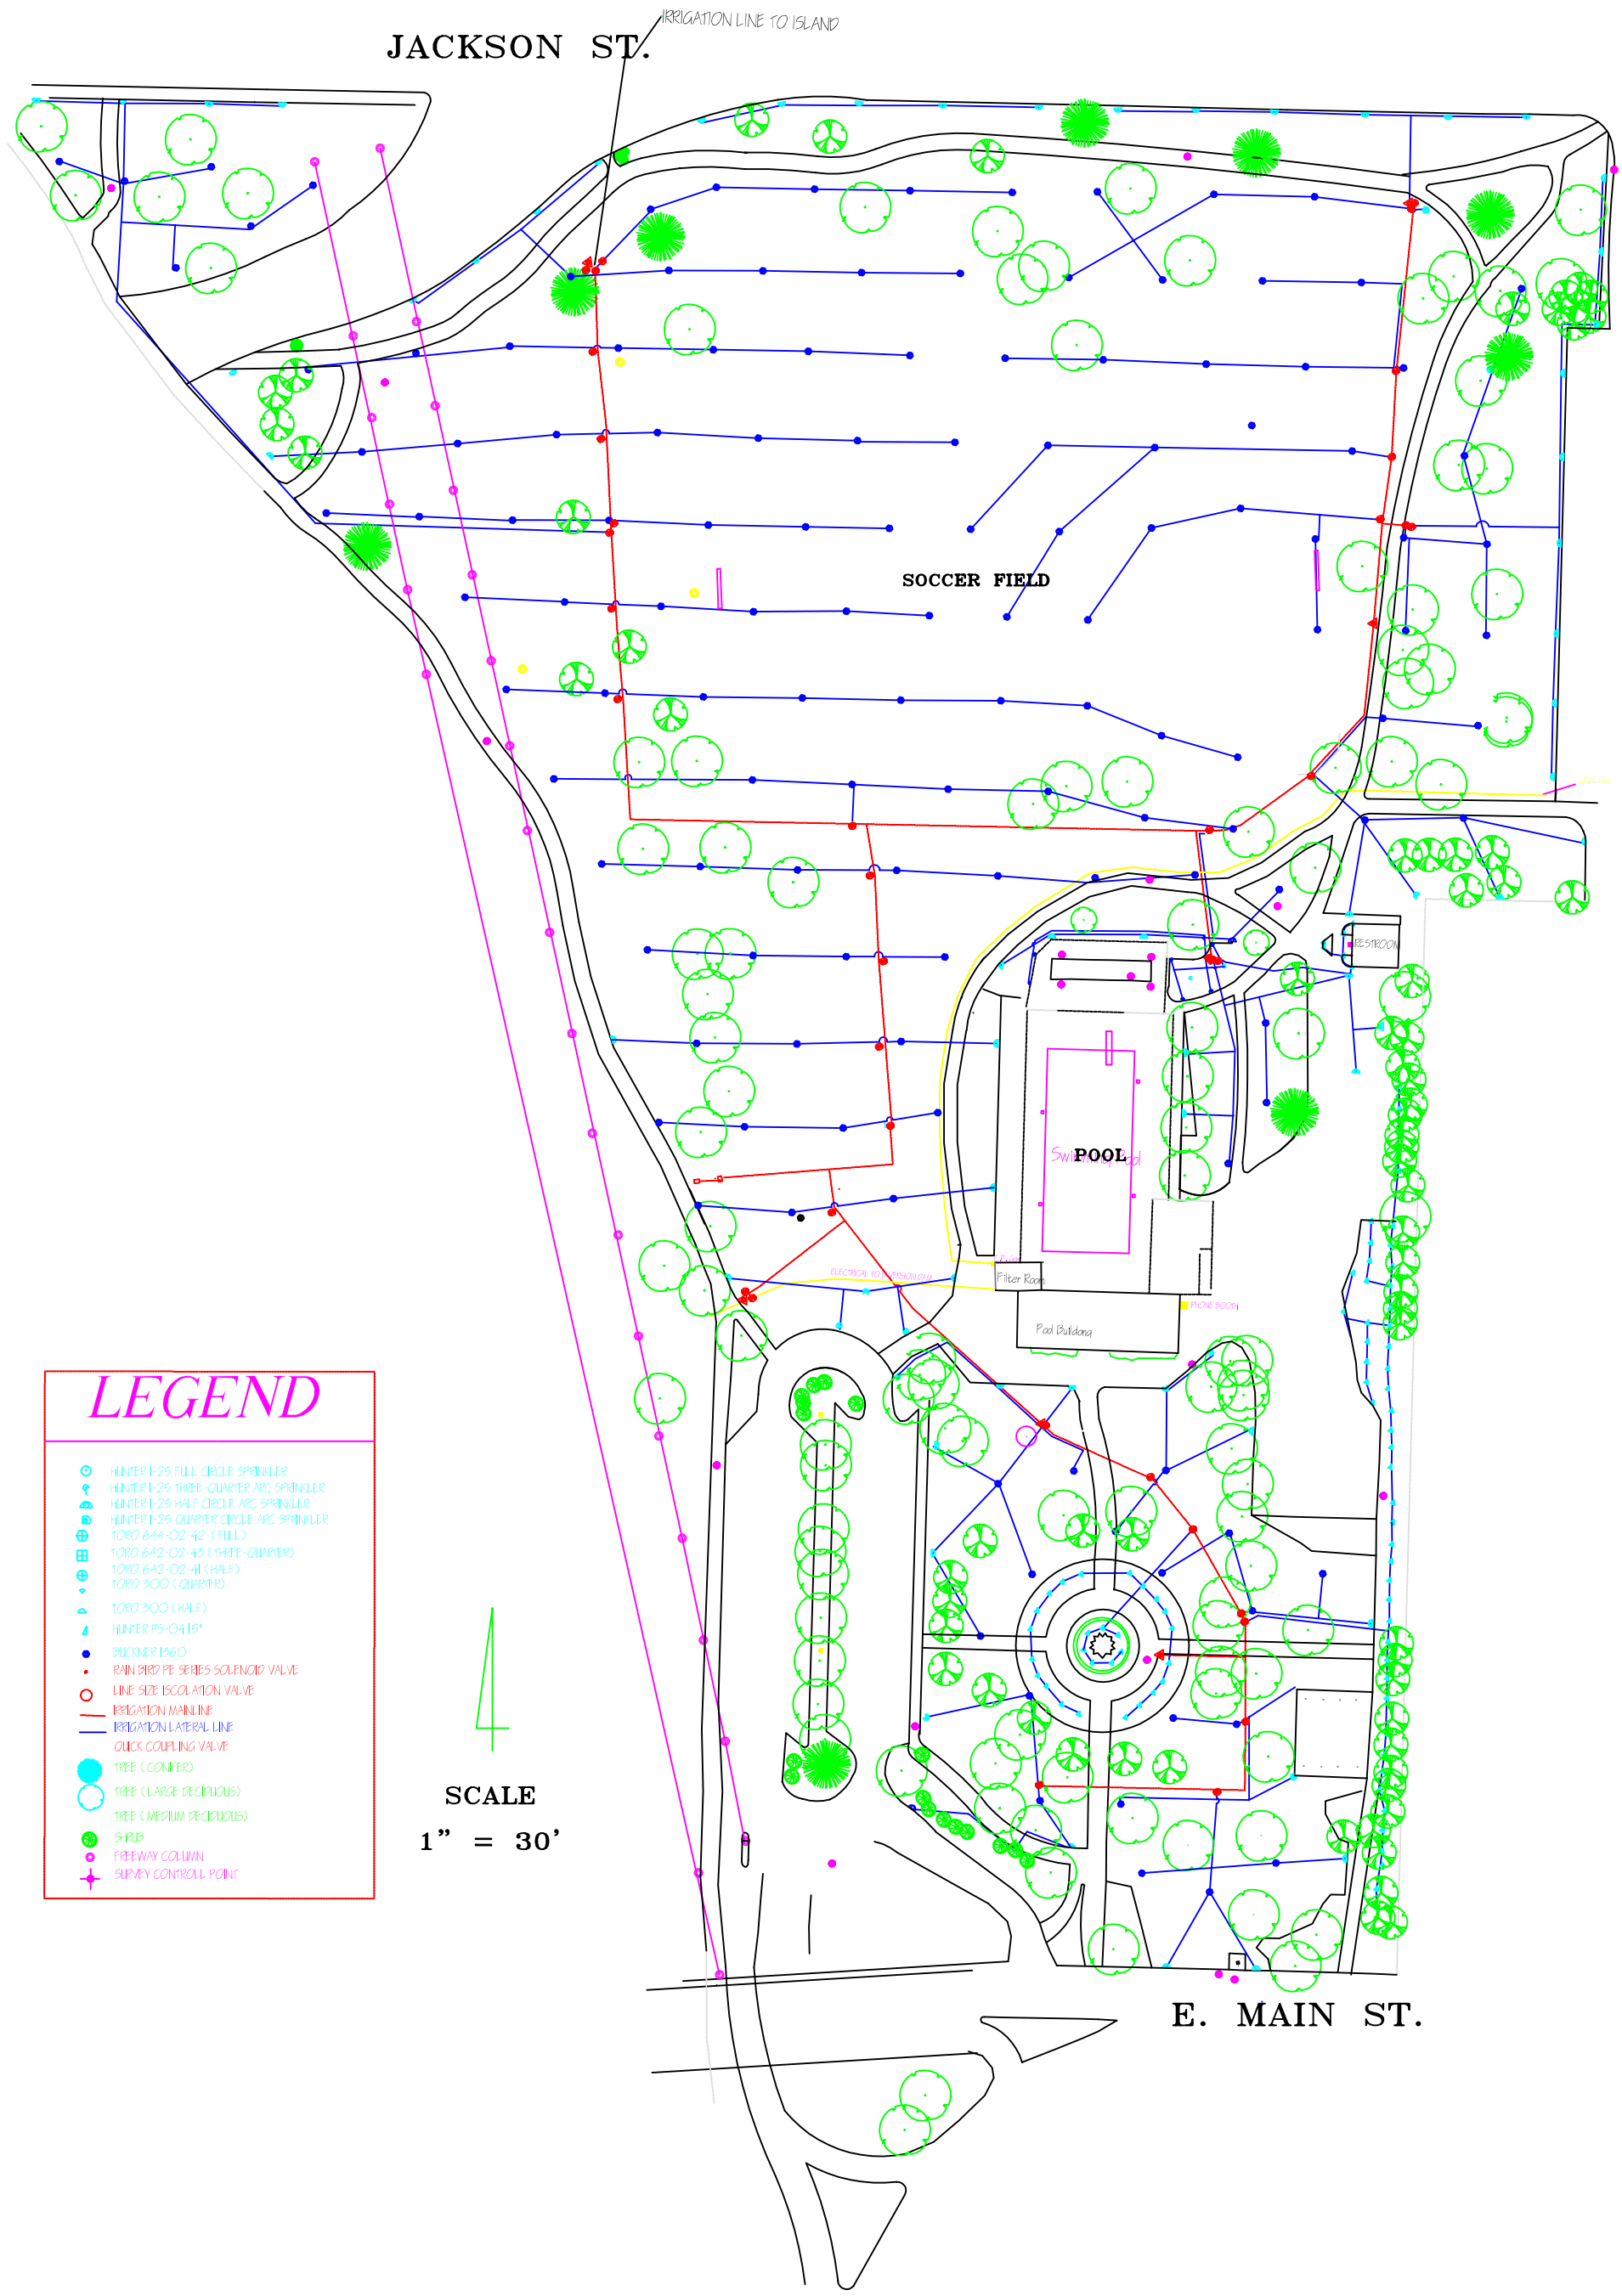# HAWTHORNE PARK